


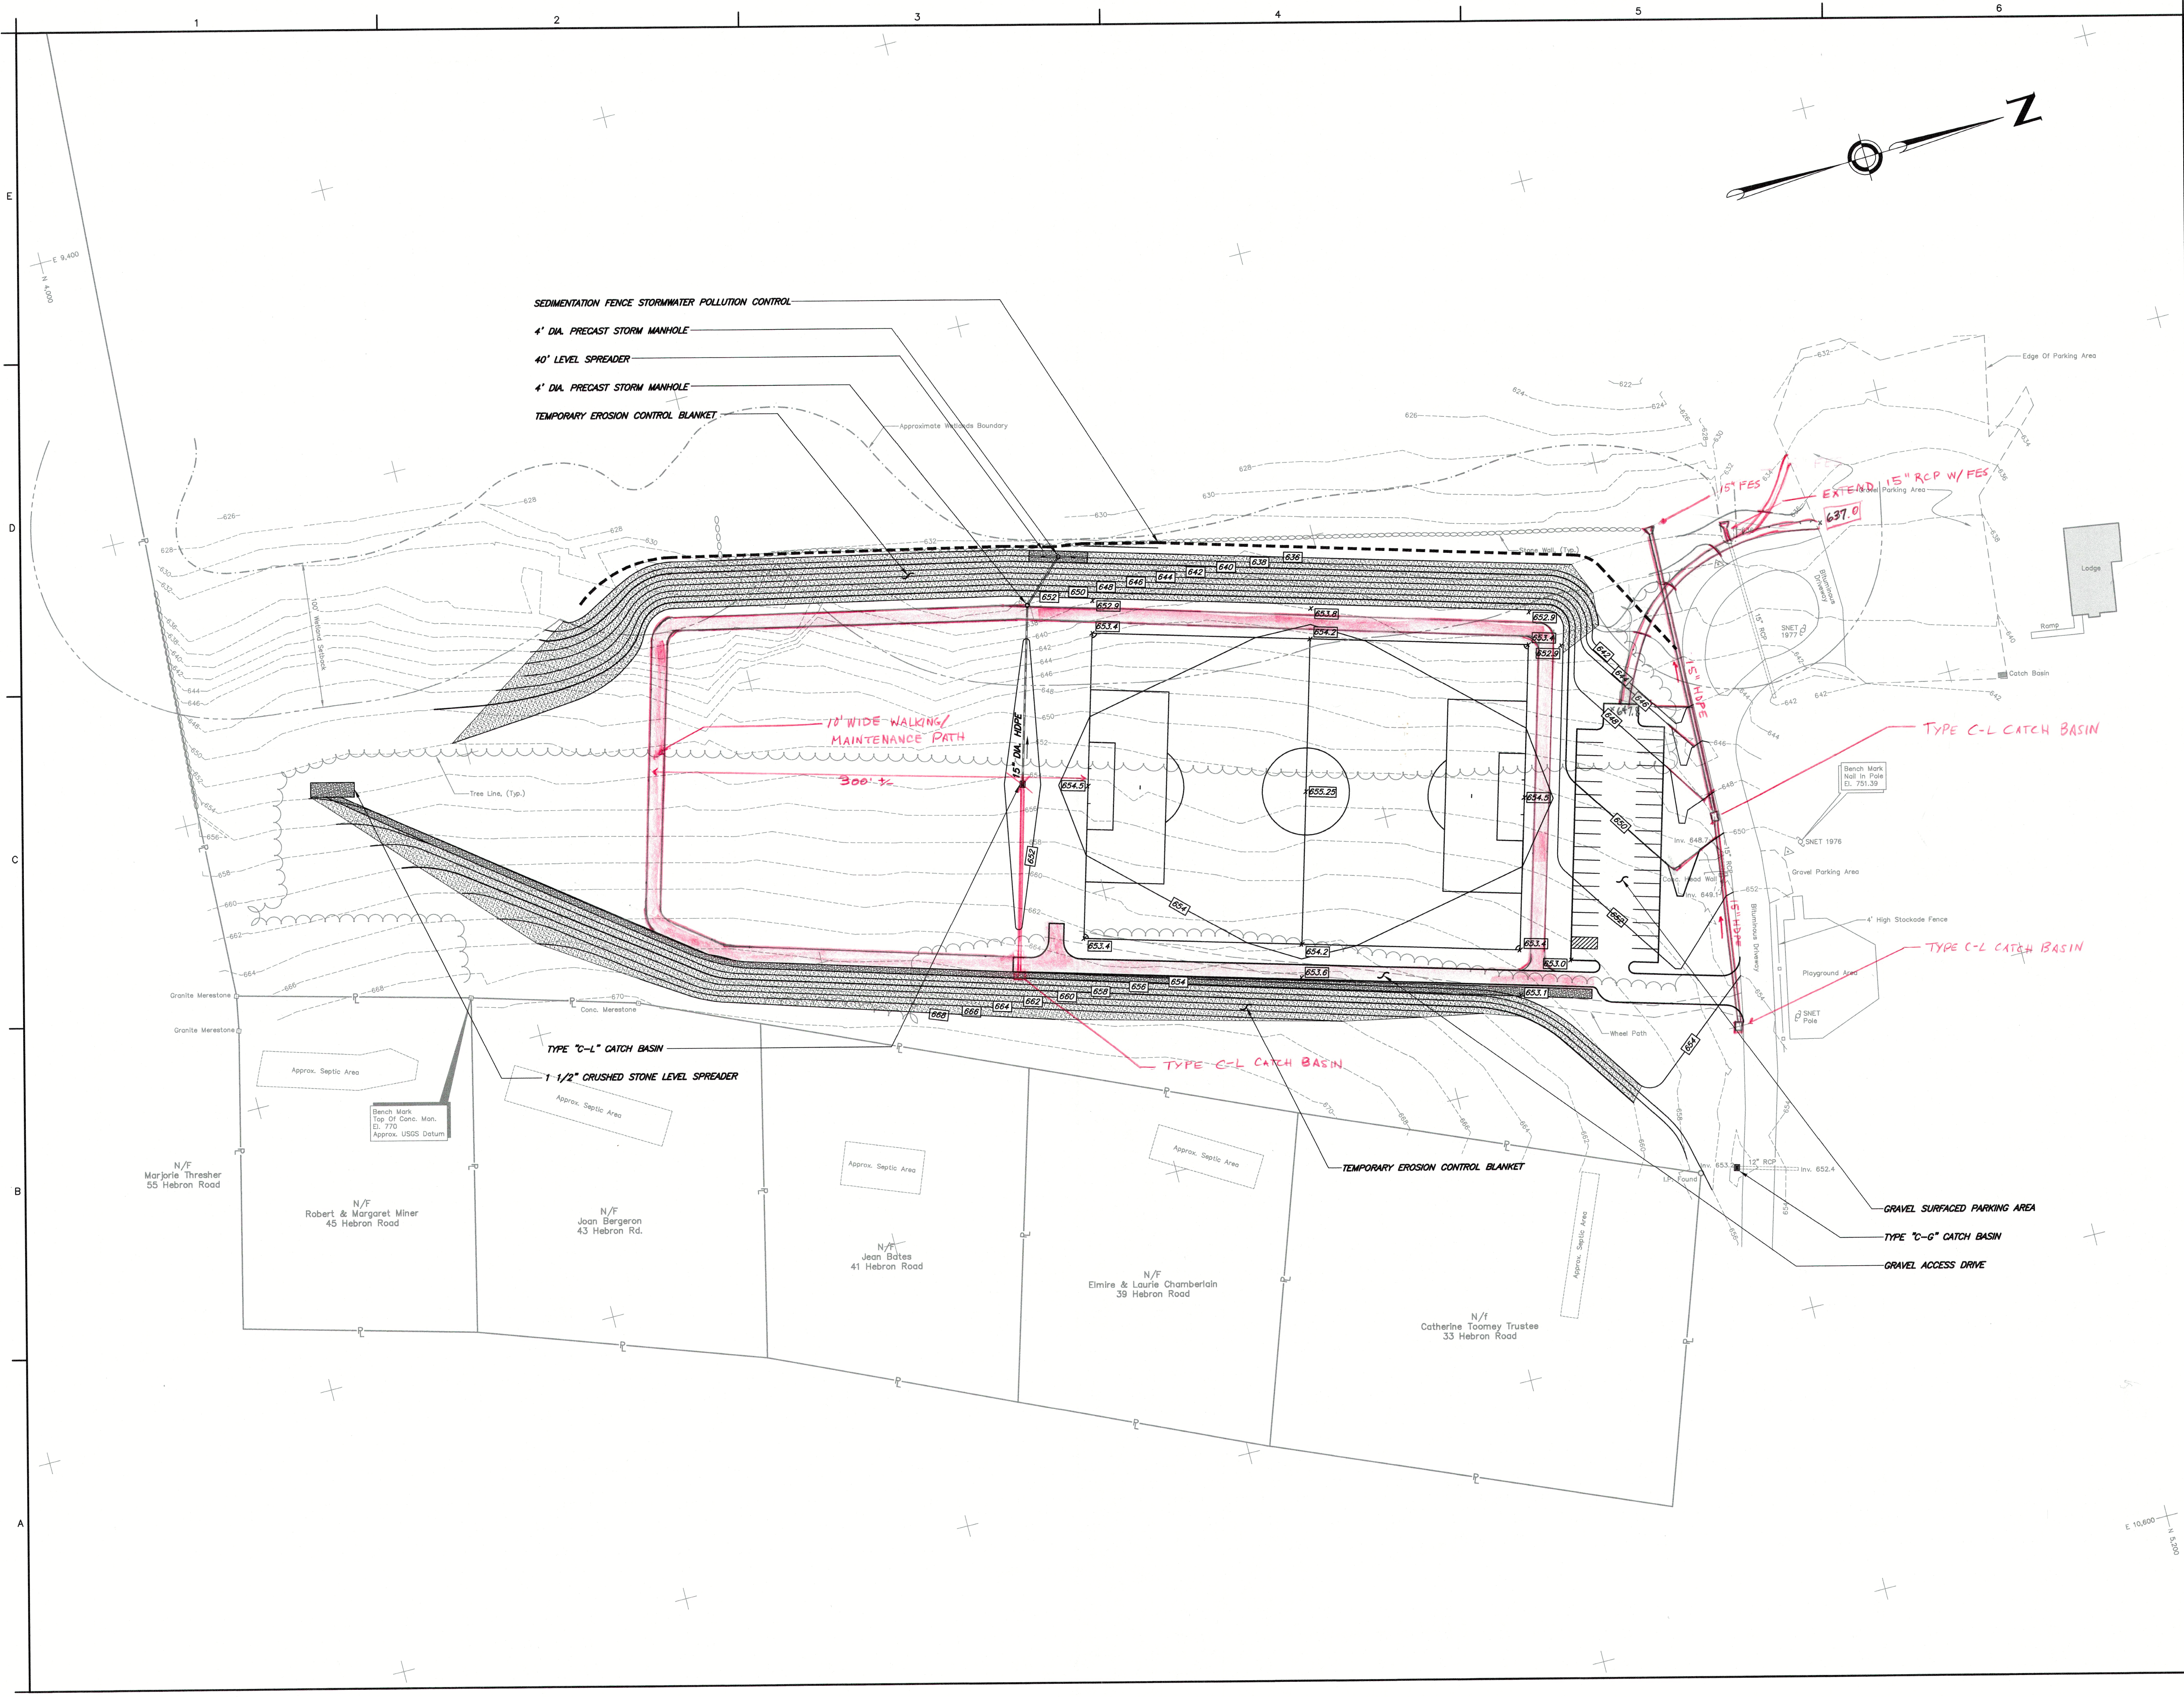

NOTES:

THIS DRAWING IS INTENDED TO BE USED FOR INFORMATION AND REVIEW PURPOSES ONLY AND IS NOT INTENDED TO BE USED FOR CONSTRUCTION.

GRAPHIC SCALE
50 40 30 20 10 0 50
SCALE: 1"=50'


HERRICK PARK
SOCCER FIELD

BOLTON
CONNECTICUT

GRADING AND EROSION &
SEDIMENT CONTROL
PLAN

PRELIMINARY DESIGN

ANY ALTERATIONS TO THIS DRAWING MADE WITHOUT THE EXPRESSED WRITTEN APPROVAL OF NATHAN L. JACOBSON & ASSOCIATES, INC. WILL BE AT THE SOLE RISK OF THE PERSON OR FIRM MAKING SUCH UNAUTHORIZED ALTERATIONS AND NATHAN L. JACOBSON & ASSOCIATES, INC. WILL NEITHER HAVE NOR ACCEPT ANY LIABILITY OR LEGAL EXPOSURE ARISING FROM SAID UNAUTHORIZED ALTERATIONS.

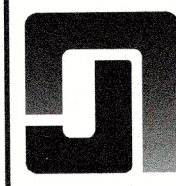 Nathan L. Jacobson & Associates, Inc.
38 Main Street P.O. Box 337
Chester, Connecticut 06412-0337
Tel: (860) 526-9591 Fax: (860) 526-5416
www.nlja.com
Consulting Civil and Environmental Engineers Since 1972

TO MY KNOWLEDGE AND BELIEF, THIS MAP IS SUBSTANTIALLY CORRECT AS NOTED HEREON.

JOSEPH M. DILLON, P.E.
CT REGISTRATION No. 22903

© COPYRIGHT 2025 NATHAN L. JACOBSON & ASSOCIATES, INC.
ALL RIGHTS RESERVED.

REVISIONS		
No.	DESCRIPTION	DATE

DATE:	MARCH 2025	SHEET No.:
SCALE:	1"=50'	
PROJECT No.:	09630011	
CADD FILE:	09630011SP	
DESIGNED:	JMD	
DRAWN:	CEB/TPH	
CHECKED:		

1 OF X